


1,473 Sq Ft

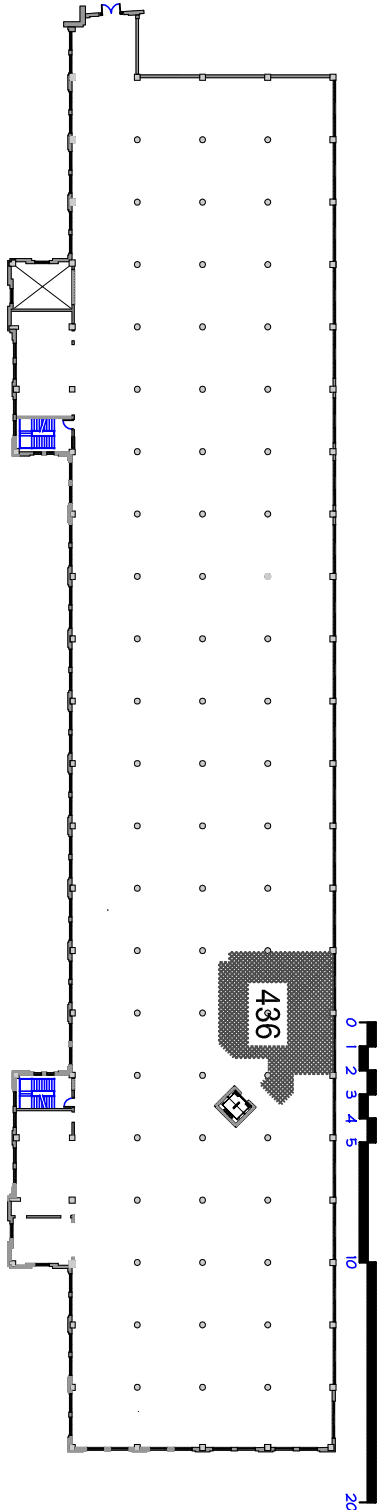

<b>436</b>	SUITE NUMBER	DRAWN BY: <b>T. BELTMAN</b>	PROJECT NAME:	DATE	REQUISITIONED FOR:	Contact: <b>Bradley Veneklas</b> Associate Broker 616.437.1065 bradveneklas@gmail.com
			<b>Clark Place Condos</b> 801 Broadway, NW Grand Rapids, MI 49504	5.10.13	as BUILT	
JOB NUMBER: 0012-264			OWNER'S APPROVAL:	DATE:		
CAD REFERENCE: ClarkPlace ASP.dwg						
PLOTTED: 5.10.13						